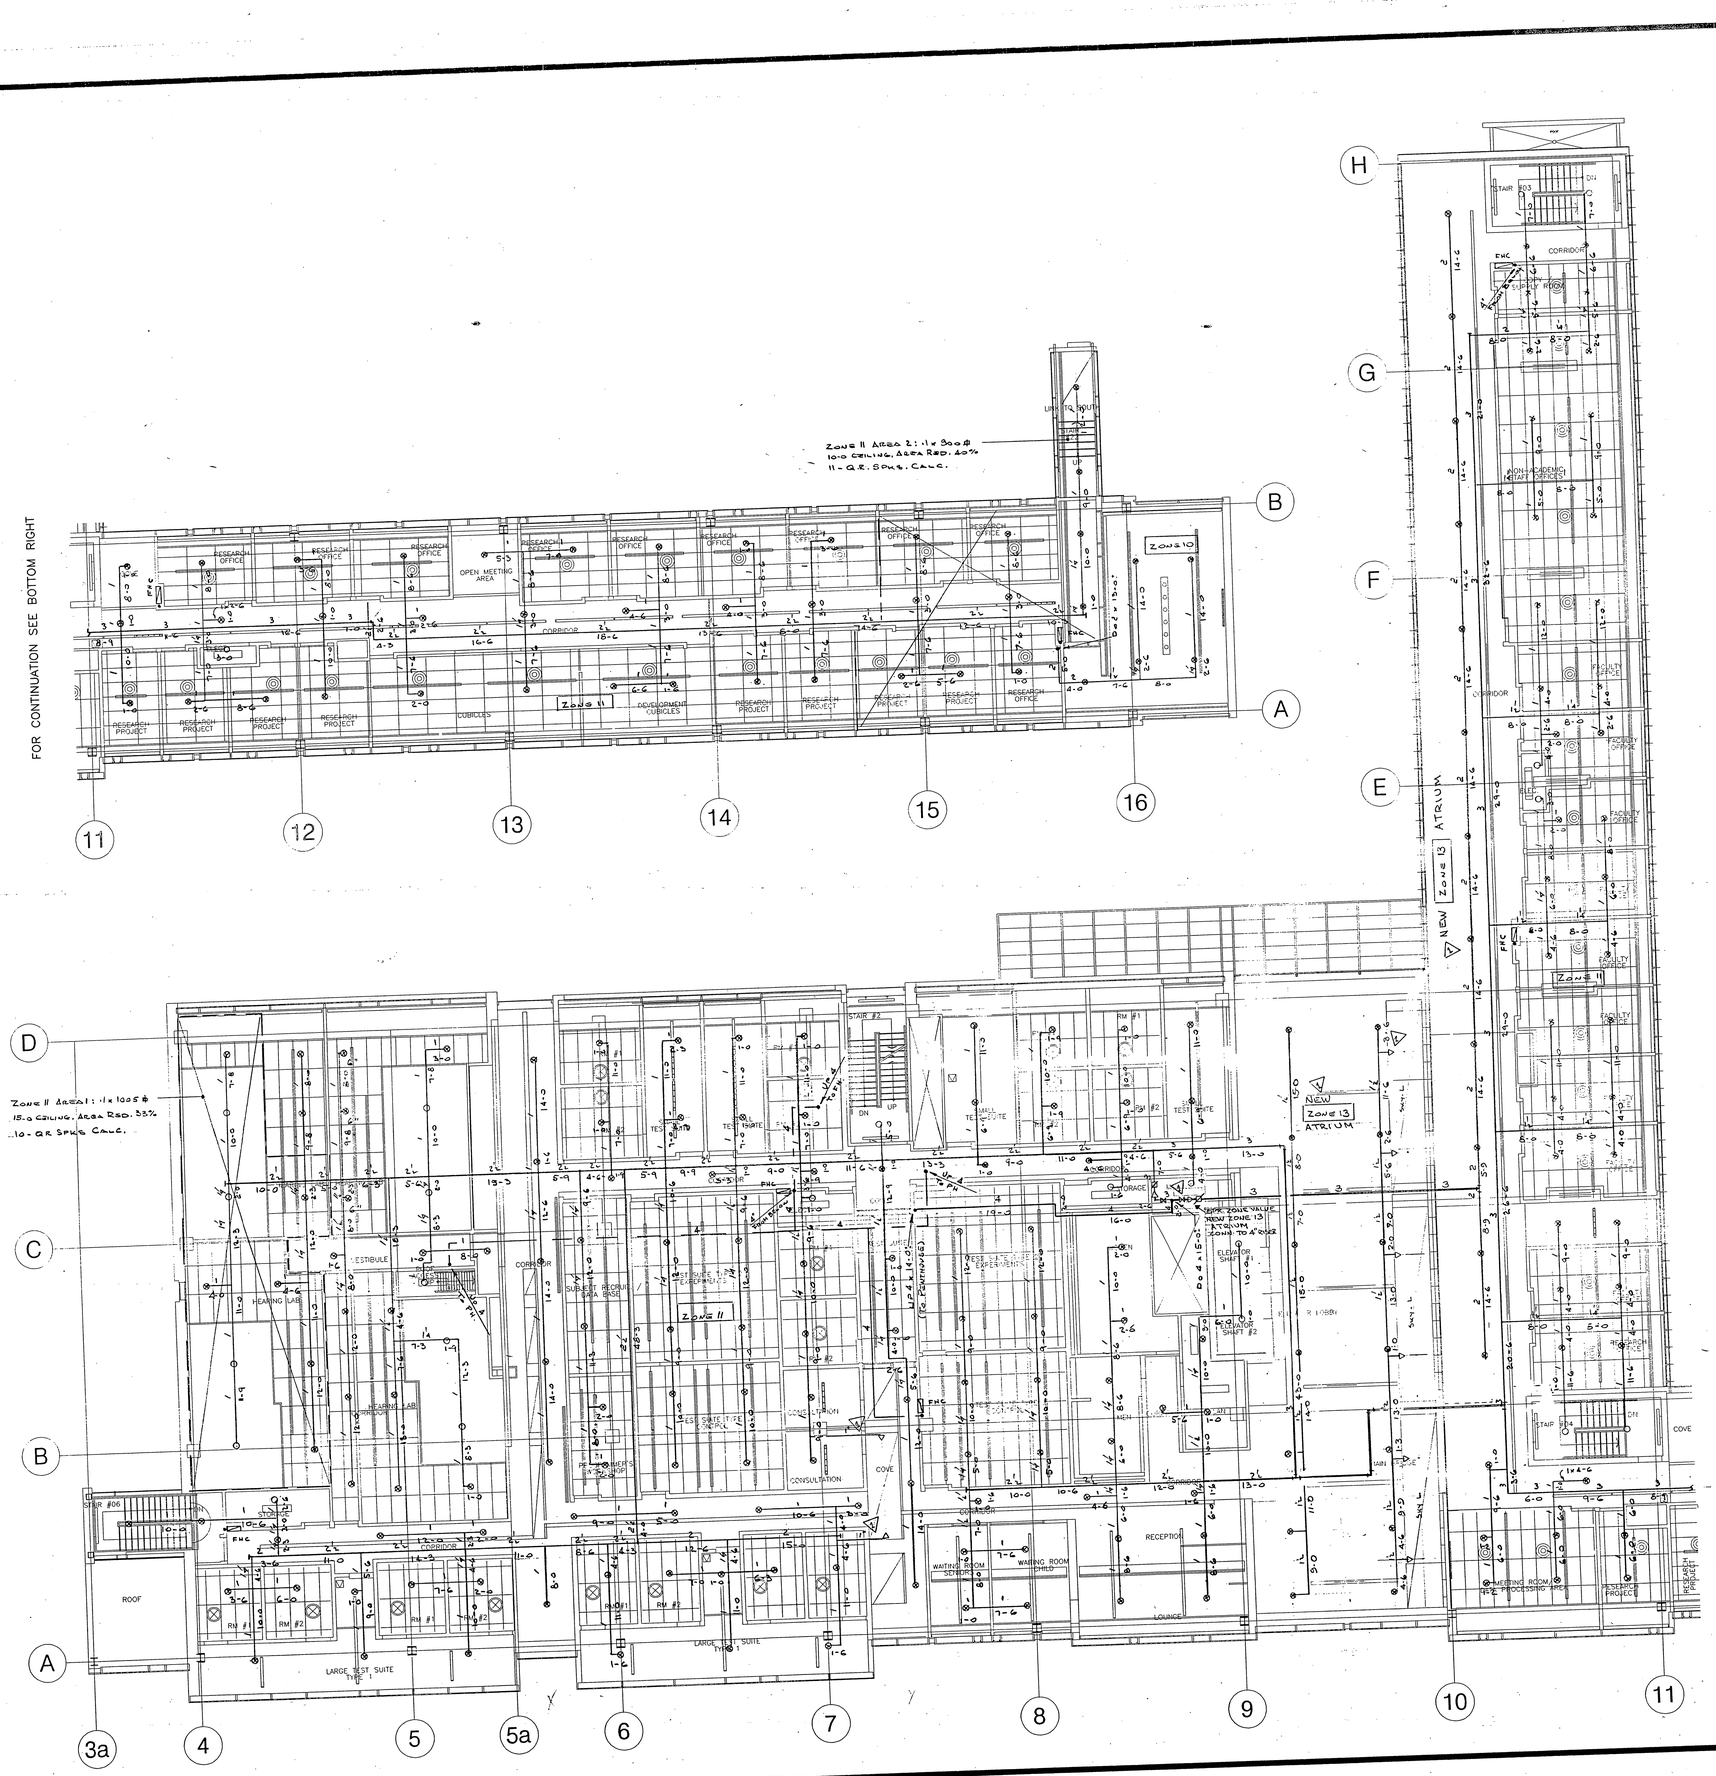

REVISIONS

1	AS ADDED IN SKYLIGHTS OVER 32ft NEW SPR. ZONE 13 CREATED THE ATRIUM ALSER SAVICKIS, PERROTTE ARCHITECTS	APR. 6 2004
2	AS PER URBAN FIRE SYSTEMS	NOV. 22 2004

NOTES

— THIS DRAWING, ASSOCIATED CALCULATIONS AND SPECIFICATIONS ARE THE PROPERTY OF THE DESIGNER AND MUST BE RETURNED AT THE COMPLETION OF THE WORK IF REQUESTED.
— DIMENSIONS ARE TO BE VERIFIED ON SITE.
— THE SPRINKLER SYSTEM IS TO BE INSTALLED AS PER N.F.P.A. STANDARD # 13, 231, 231-C AND O.B.C. STANDARDS, (IF APPLICABLE).
— ALL PIPING SHALL INCLUDE FOR OFFSETS IN BRANCH LINES AND MAINS WHERE REQUIRED.
— ALL MATERIALS TO BE U.L.C. LISTED AND APPROVED BY LOCAL AUTHORITIES.
— ALL UNDERGROUND WATERMAIN TO BE INSTALLED ACCORDING TO LOCAL AUTHORITIES AND INSURANCE CO. STANDARDS.
— INSTALL DRY TEMPERATURE HEADS WHERE REQUIRED AS PER N.F.P.A. STANDARD # 13.
— ALL SPRINKLER BRANCH LINE MEASUREMENTS ARE GIVEN AS CENTER LINE TO CENTER LINE DIMENSIONS.
— ALL CENTER LINE TO CENTER LINE DIMENSIONS. (CC/CTO PIPE)
— ALL OTHER BRANCH LINE MEASUREMENTS ARE GIVEN AS CENTER LINE TO DEVELOPED LINE (DEAD END PIPE)
— ALL CENTER LINE TO DEVELOPED LINE MEASUREMENTS ARE GIVEN AS CENTER LINE TO DEVELOPED LINE DIMENSIONS. (THIN WALL PIPE)
— DEVIATED DISTANCE IN INCHES FROM CENTER LINE OF PIPE TO UNDERSIDE OF CEILING.
— RN DENOTES RIDER NIPPLE.
— DN DENOTES DOWN.
— ALL SUPERVISED VALVES (FLOW, SPRINKLERS, SWITCHES AND LOW AIR PRESSURE SWITCHES) ARE TO BE CONNECTED TO FIRE ALARM SYSTEM. (IF FAS IS INSTALLED)
— CONTRACTOR TO VISIT SITE TO DETERMINE EXACT LOCATION AND CONTRACTOR TO VISIT SITE TO DETERMINE EXACT LOCATION AND CONDITIONS. ANY DISCREPANCIES NOTED AS INDICATED ON DRAWINGS OR MAJOR DISCREPANCIES TO BE REPORTED TO THE DESIGNER PRIOR TO FABRICATION AND INSTALLATION.

OWNER (OR OTHERS) TO PROVIDE ADEQUATE HEAT IN ALL AREAS OF BUILDING SUBJECT TO FREEZING THAT ARE PROTECTED BY A WET TYPE SPRINKLER SYSTEM.

ALL GLASS BULB TYPE SPRINKLERS TO BE OF RECENT ISSUE, MANUFACTURE DATE OF AT LEAST YEAR 2001.

WE HEREBY CERTIFY THAT THESE DRAWINGS REPRESENT THE BUILDING AS BUILT

URBAN
MECHANICAL CONTRACTING LTD.
AS BUILT DRAWING
23-Nov-2004 per

DESIGN CRITERIA

Zone 11: Light Hazard 1 x 1500 ft
or Area Reduced for Q.R. Sprinklers.
Zone 7 Elevator Lobby: Light Hazard 1 x 1500 ft

	Q.R. SPRINKLERS	
○	155° ½" UPRIGHT SPKS.	23
⊗	155° ½" CVR. PENDANT	234
△	155° ½" SIDEWALL SPKLR	8

URBAN FIRE SYSTEMS LTD.
Installation, Design, & Maintenance of Fire Sprinklers & Alarms

DISANO DESIGN
7181 WOODBINE AVENUE
SUITE 107
MARKHAM, ONTARIO
L3R 1A3
T 905-477-4474
F 905-477-4268
E disano@disanosprinkler.on.ca

NORTH

STAMP

LICENSED PROFESSIONAL ENGINEER
R.A.SEVERINI
PROVINCE OF ONTARIO

PROJECT
UNIVERSITY OF TORONTO
COMUNICATION, CULTURE AND INFORMATION TECHNOLGY BLDG.
MISSISSAUGA, ONTARIO

DWG TITLE
PROPOSED SPRINKLER LAYOUT
THIRD LEVEL

DATE: MAY, 2003	PROJECT NO.: 03-6563
SCALE: 1:100	
DWN BY: A.E.	DWG NO.: SP8
ISSUED FOR REVISION NO. ⚠⚠	OF 9

REVIEWED BY
DATE aug 17/04
MISSISSAUGA FIRE AND EMERGENCY SERVICES